
PLAN
of Portions 783,796 & 797.
MUKIM OF PETALING.
DISTRICT OF KUALA LUMPUR.

Scale Four Chains to an Inch.

Note:

All Bearings on this plan are on the Meridian of the Trig: on Bkt: Asa.

Lot 783 now Lot 3195 & part of Lot 3199 C.P. 20254

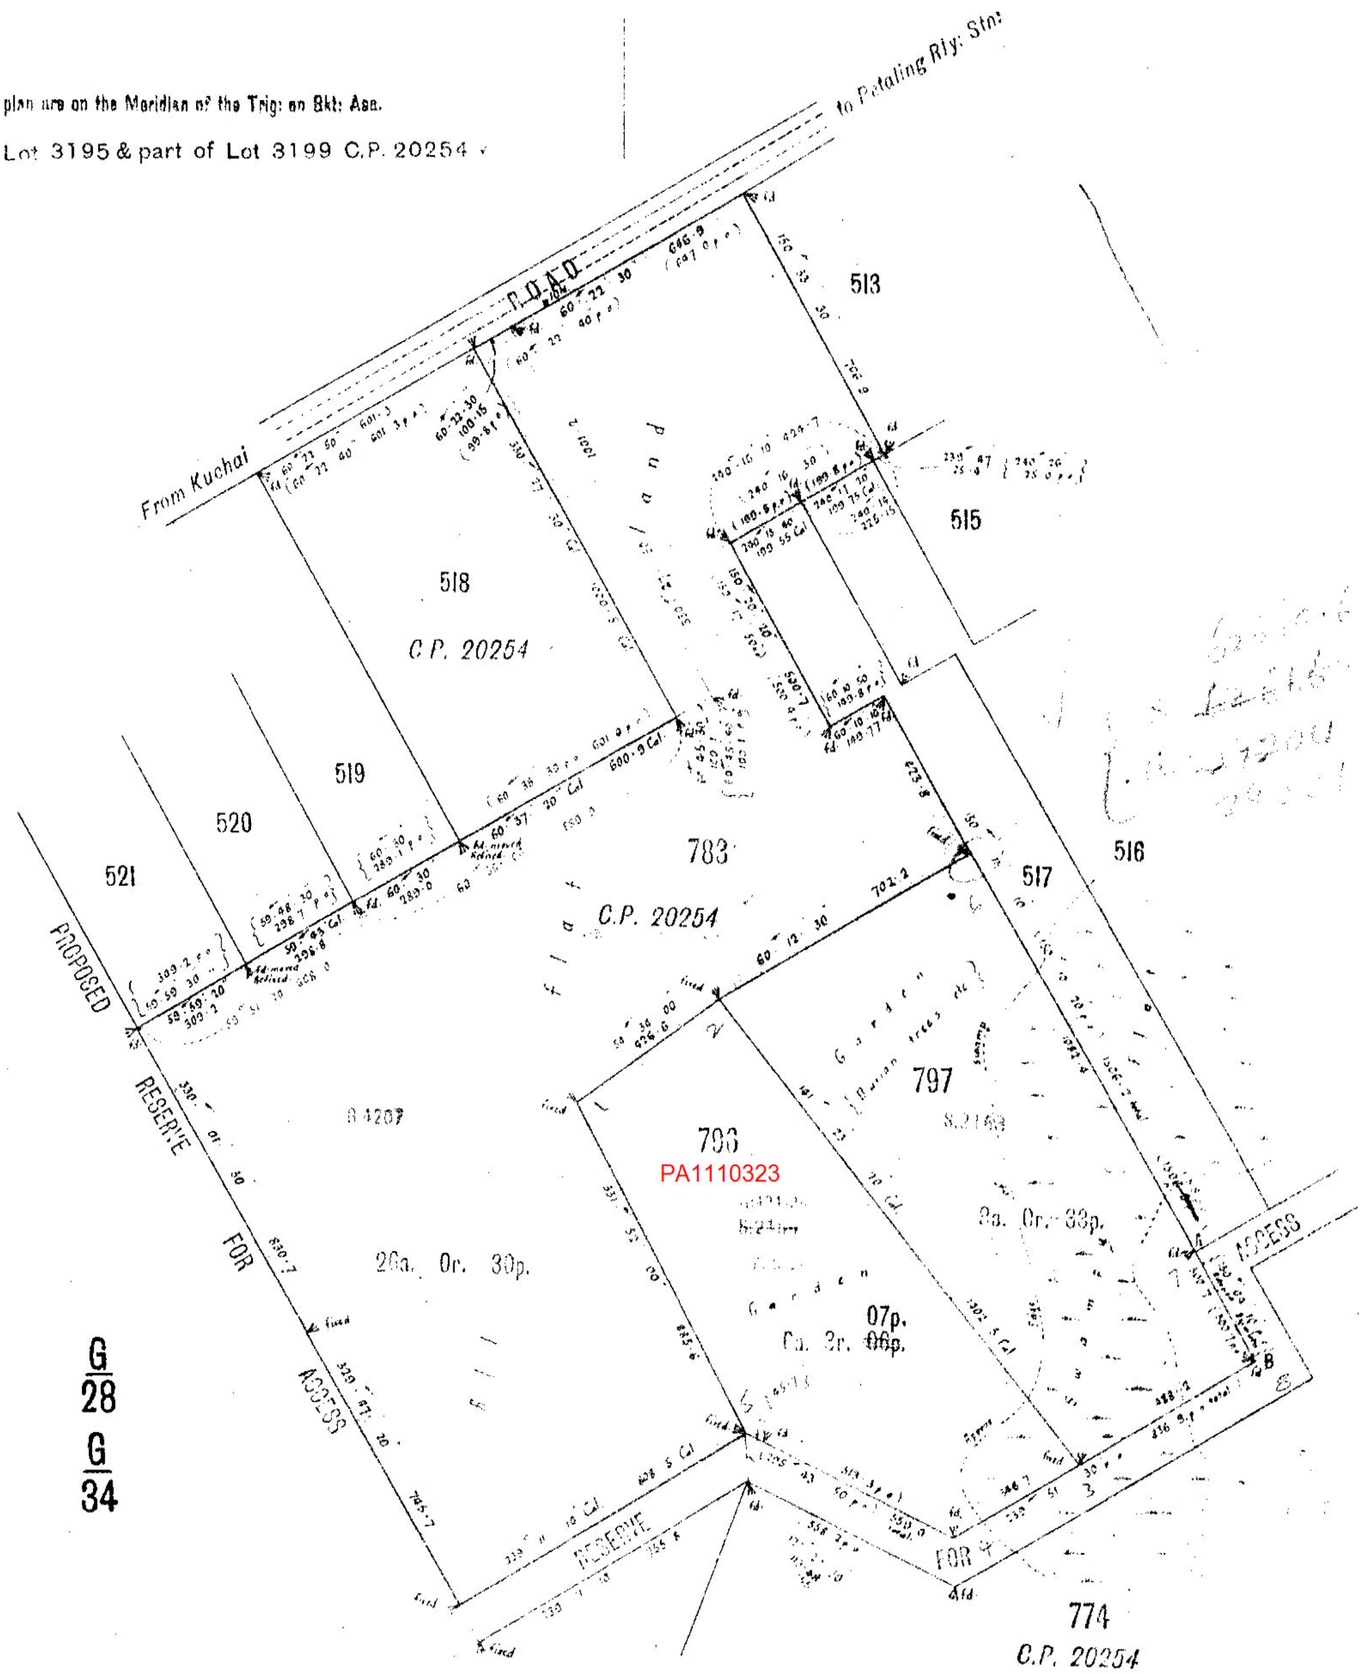

PA1110323

G 28
G 34

Svy: 965
06

Boundaries of portions 796 to 797 examined and found correct

15.3.07.
Settlement Officer

Azimuth taken from A. B.

Drawn by [illegible]

Examined by [illegible] 27/3/07 Field Book 1309 pp. 43 to 45

Charted by [illegible] Length of pipes used

Plan approved [illegible] 12 [illegible] 07 Date of Issue [illegible] 07

I hereby certify that I in person made and on 22 1 07 completed the survey represented on this plan, on which are written the bearings and lengths of the lines measured by me, and I declare that the survey has been executed in accordance with the Regulations.

[illegible] 22/3/07 Surveyor.

Extracts for portions 796 & 797 prepared and forwarded Vide Svy: 201-07
do 796 do 228 - 26

Cal: Book Vol: 31 pp 189 to 192

5722. C - 93

G 28 & 34