55611

BUILDING

BUILDING

4102

55616 LALUAN PERKHIDMATAN

4103

SIMPANAN JALAN

4104


COLUMN

RETAINING WALL


RETAINING WALL

4105

4106

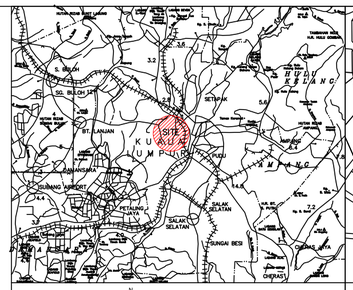

KEY PLAN
SCALE : 4 MILE TO AN INCH

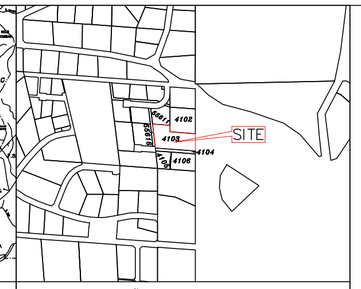

LOCATION PLAN
SCALE 1 : 6336

SCALE 1 : 250
STD SHEET : 85-B

PROJECT : -

DETAILS SURVEY ON LOT 4103
MUKIM OF KUALA LUMPUR
DISTRICT OF KUALA LUMPUR
WILAYAH PERSEKUTUAN

LEGENDS :-

1. CHAIN LINK FENCE
2. CONCRETE FENCE
3. GATE
4. RETAINING WALL

NOTE :-

1. ALL MEASUREMENTS ARE IN METRES.
2. ALL LEVELS ARE BASED ON BM W0113 (RL=32.085m)

SURVEYED BY :	FOO	SEPT. 2013
DRAWN BY :	AFIKAH	SEPT. 2013
CHECKED BY :	KENNETH	

LICENSED LAND SURVEYOR :

Sr. LAU WEI SENG
B. GEOMATICS (MELB) HONS, R.I.S.M (M)
Jurukur Tanah Yang Diiesen Di Bawah Akta 458
PERUNDING UKUR TEKUN
20-2, JALAN PJU 5/15
DATARAN SUNWAY
KOTA DAMANSARA
47810 PETALING JAYA
Tel : 03-61579988 Fax : 03-61572145 E-mail : main@put.com.my

PLAN NO : PUT/W2995/13/DT/P1