

LOTS 5607-5620

MUKIM OF AMPANG

DISTRICT OF KUALA LUMPUR

Scale One Chain to an Inch


I, **YEOW HO HUAT**, a surveyor
 licensed under the Licensed Land Surveyors Ordinance No. 11
 of 1958, certify that the survey from which this plan has been
 prepared was carried out and marked on the ground by me or
 under my immediate personal direction and supervision in the
 field in strict accordance with the Licensed Land Surveyors
 Regulations, and that this plan correctly represents that survey
 completed on the 11th day of September 1972
 Dated this 11th day of September 1972
[Signature] Surveyor.
 Licensed under Ordinance No. 11 of 1958

S. 6500

E. 24000

Notes:

- Lots 5607 & 5608 being subdivision of lot 4354 (C.P. 24743)
- Lots 5609 & 5610 being subdivision of lot 4355 (C.P. 24743)
- Lots 5611 & 5612 being subdivision of lot 4356 (C.P. 24743)
- Lots 5613 & 5614 being subdivision of lot 4357 (C.P. 24743)
- Lots 5615 & 5616 being subdivision of lot 4358 (C.P. 24743)
- Lots 5617 & 5618 being subdivision of lot 4359 (C.P. 24743)
- Lots 5619 & 5620 being subdivision of lot 4360 (C.P. 24743)

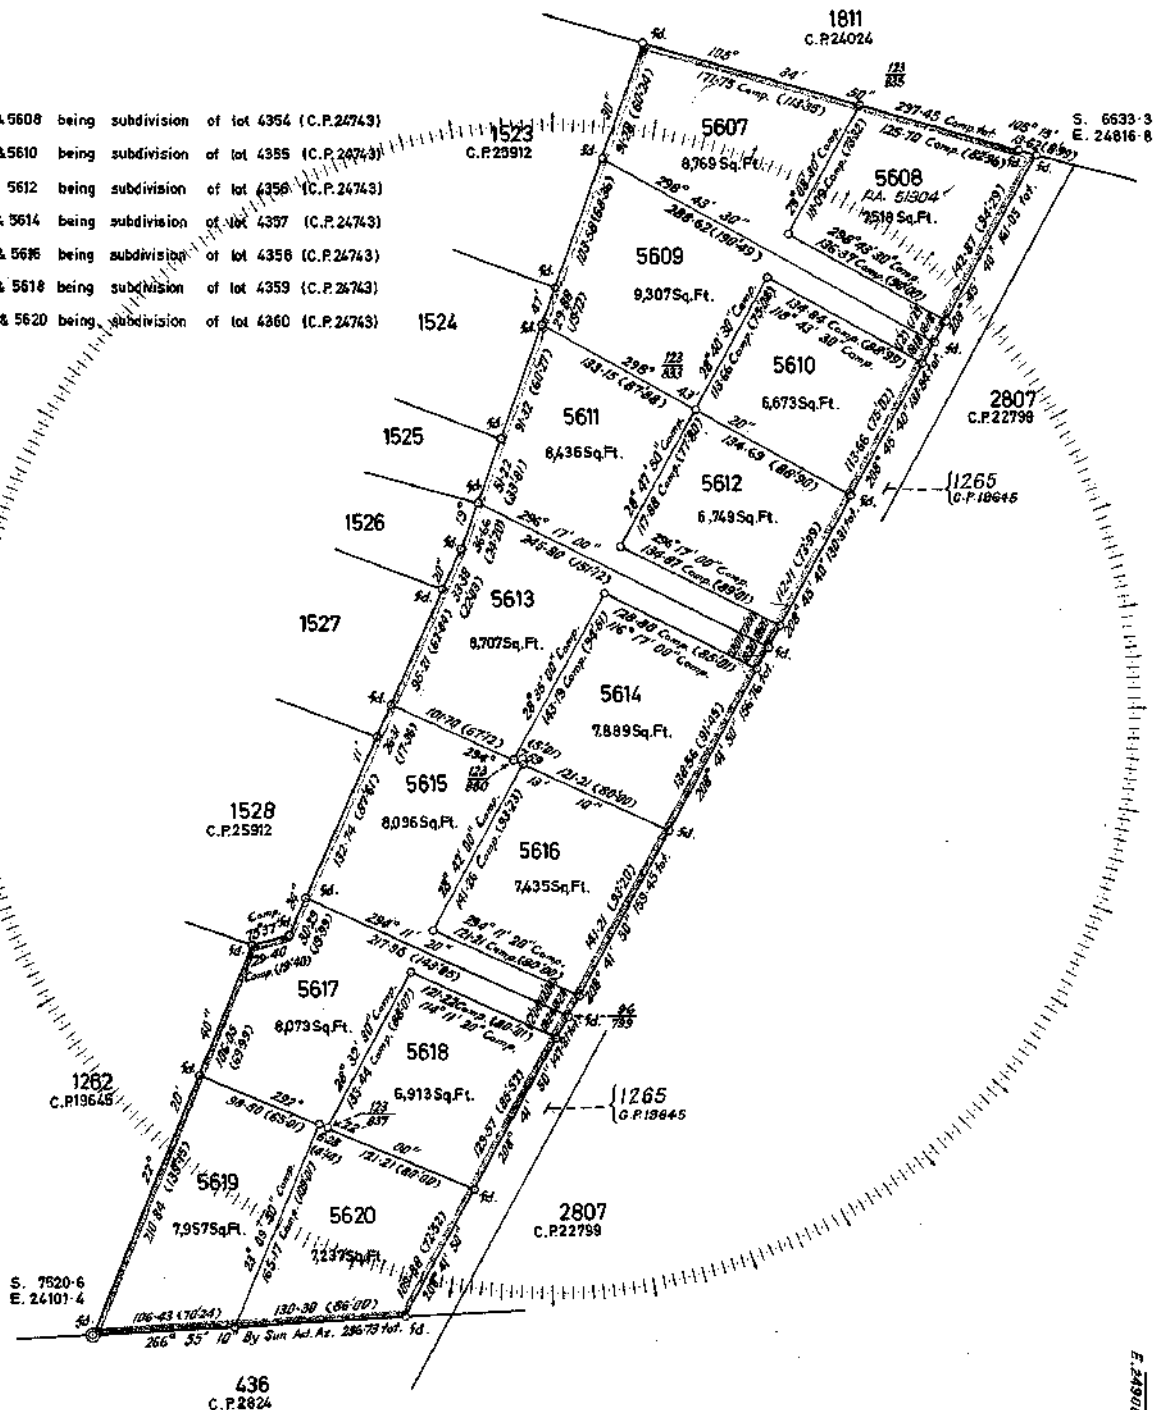

Std. Sheet 86-A

First Class Survey

Svy. Ref. P.U.B.L. Sel. 116-70

Examined by *[Signature]*
 Approved *[Signature]* 26. 2. 73

L.O. Ref. P.H.T.K.L. 6-1723-69

Cal. Vol. 600 pp. 37-43

Field Book 19271

C.P. 26481