


SUB-CIRCUIT 7
CIRCUIT 10
KLANG
BANDAR SHAH ALAM

KLANG R.

Scale Four Chains to an Inch

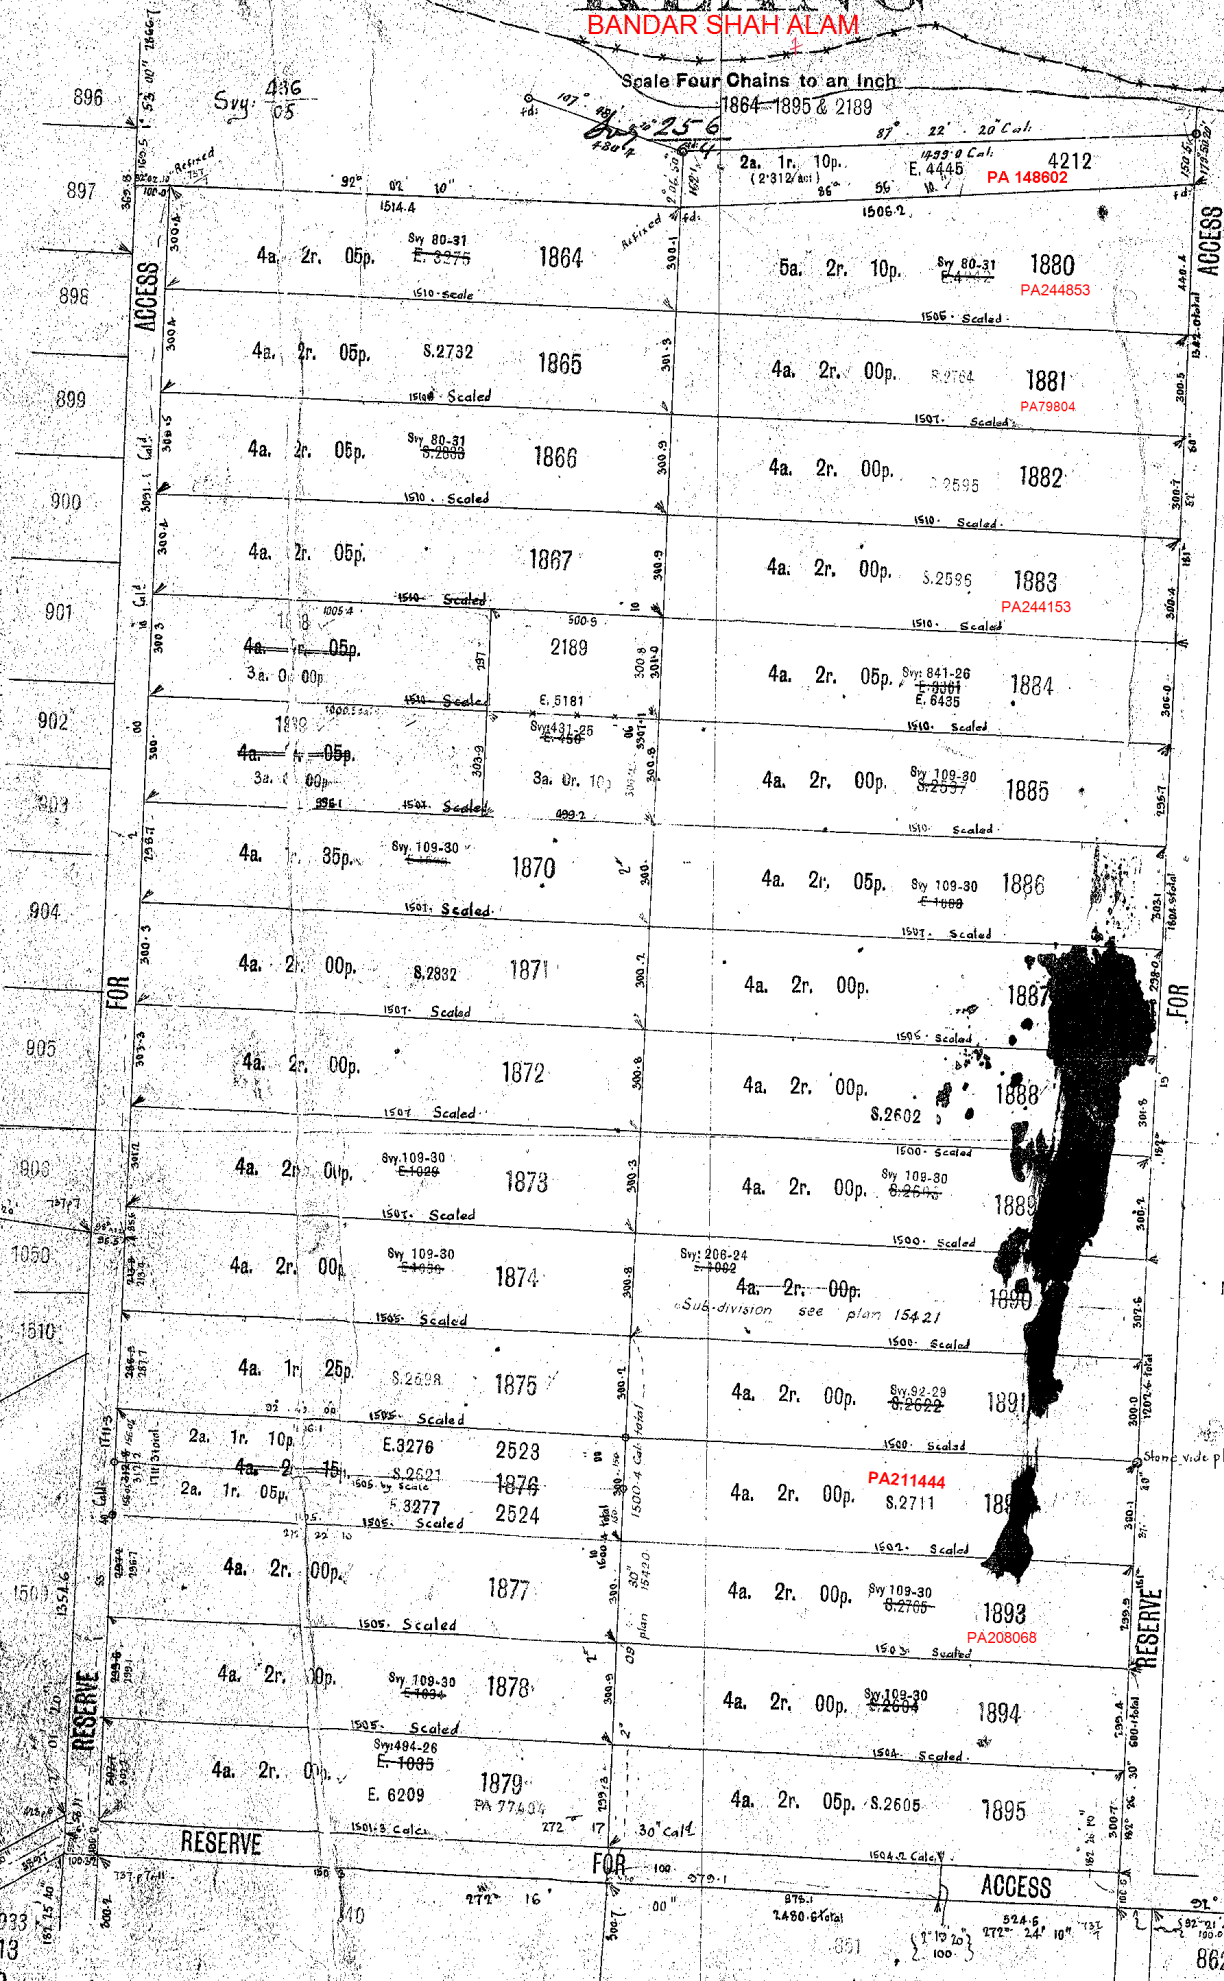

Note:
For Portion 4212 See F. B. 208 pp 1 & 2 Svy. 230-18
For subdivision of Port. 1890 see plan 15421

Lot 2189 coloured yellow and Extract
L.C.10 A forwarded vide R.S.S. 479-62

L. Khan
f. Ketua Juru Ukur

Note:
Sebahagian dari Mukim KLANG, Daerah KLANG telah diisytiharkan
menjadi Bandar Shah Alam, Daerah KLANG melalui P.W.K. Negeri
Selangor No. 2211 bertarikh 16.6.2022

Lot 1864 - 1895 & 2189 masing-masing telah ditukar menjadi
Lot 1864 - 1895 & 2189 Bandar Shah Alam

11/11/2024

(S. LOOI KAM SENG)
Pengarah Ukur dan Pemetaan,
Negeri Selangor

Note
All bearings on this plan are on the Meridian of the Trig. on U.K. Ass.

Stone vide plan 15421

Extract for portion 4551 prepared and forwarded Vide Svy. 436-12

" " 2524 " " 1916-16

" do " 1880 " do " 487-18

F. B. No: 737 p.38 1878 do " 77-29

do 1873 do " 44-30

do 1873 do " 44-30

Drawn by *L. Khan* 1916

Checked by *L. Khan* 1916

Charted by *L. Khan* 1916

Plan approved *L. Khan* 1916

Sub-Cir: 5 Cir: 10

Extract for Portion 1887 forwarded Vide Svy. 302-19

do 4212 do 230-18

do 2189 do 104-21

do 1879 do 486-05

Note
For alteration of Ports 1868 & 1869 vide field note enclosed in Svy. 436-05
For subdivision of Port: 1878 vide F. B. 2794 p.2 Svy. 786-11

Extract for Portions 1870 & 1874 forwarded vide 44-30

Boundaries of portions 1864 to 1895 examined and found correct

Extracts for portions 1864 to 1895 & 2189 prepared and forwarded Vide Svy. 436-05

Extract for portion 1864 220-12

Extracts for portions 2523 & 2524 780-11

1893 & 1894 77-29

1889 44-30

Settlement Officer