

No. Fail JM 972 / Bkt Riman.

Rajah di muka

[illegible]

[illegible]

No. Fail

Rajah di muka

[illegible]

No. Fail

Rajah di muka 11

[illegible]


No. Fail

Rajah di muka

Stesen	BEARING / SUDUT			Dari Stn.	GARISAN		Ke Stn.	Sudut Pugak (±)	Jarak	Sudut	Jarak Antara Tupang	Jarak Mukamat
	Penyilang Kiri	Penyilang Kanan	Purata		Bearing Mukamat							
												
9-15	51 23 35	132.978	✓									
	51 23 19	132.955	PO									
	+21"	+0.022										
9-9	68 28 91	97.099	✓									
	68 26 36	97.088	PO									
	+5"	+0.011										

DAERAH KLANG.
MUKIM KLANG.
100 A S C
TANPA SKALA

DAERAH KLANG.
MUKIM KLANG.
100 A S C
TANPA SKALA

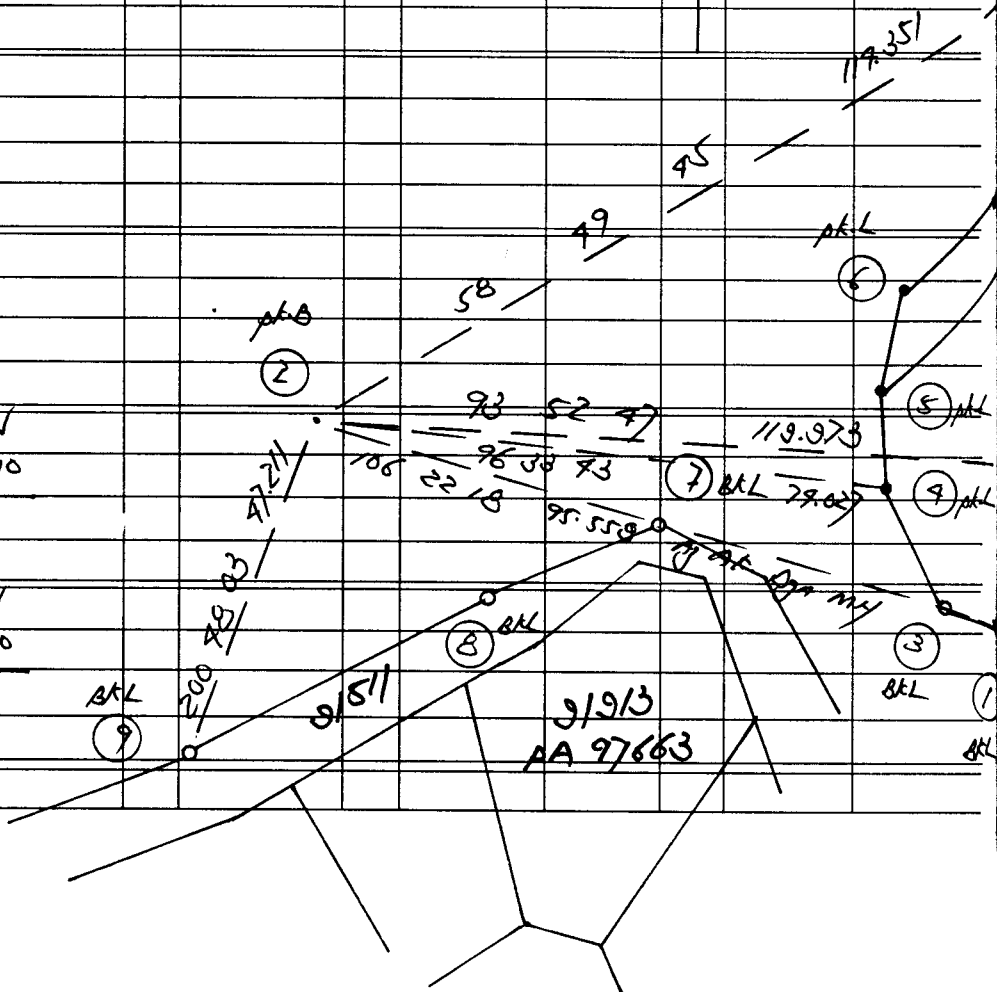

CERAPAN MATAHARI BAGI AZIMUT

Penilik _____ Hari _____ Tarikh _____ Bulan _____ Tahun _____
 Stesen _____ T.R. _____ B.K. _____ Ms. _____ Tiodolait (Jenis) _____ 1 Bah. Aras.Ufuk = a _____

Penilik: JM972 Bkt Rimau Tarikh: 07/11/2009

Stn. 2 Koordinat: S20192 B19332 Selangor

T.R. 1 B.K. Ms.

Tiodolit Satu bah. aras ufuk:

Waktu	Sasaran	Ufuk	Gelembong	Puguk
	T.R.	0 00 00		
8 03	M.H.	1 27 44	76 02 35	Waktu purata 8 03 30
8 03	M.H.	0 55 10	75 57 17	Beza dari U.T. - 8 00 00
8 04	M.H.	180 55 50	284 09 40	U.T. 0 03 30
8 04	M.H.	181 29 51	284 14 00	Deklinasi - 16 15 05
	T.R.	180 00 10		
	T.R.	0 00 00		
8 05	M.H.	1 31 20	75 37 45	Waktu purata 8 05 30
8 05	M.H.	0 58 27	75 33 30	Beza dari U.T. - 8 00 00
8 06	M.H.	180 59 02	284 33 17	U.T. 0 05 30
8 06	M.H.	181 33 07	284 37 22	Deklinasi - 16 15 07
	T.R.	180 00 10		

	Set 1	Set 2
Sudut pugak	14 05 57	14 29 51
Pembetulan	- 0 03 19	- 0 03 13
Altitud	14 02 38	14 26 38
Jarak kutub	106 15 05	106 15 07
Latitud	2 59 29	2 59 29
Azimut M.H. yang dikira	107 34 27	107 37 44
Purata ke M.H.	1 12 09	1 15 29
Selisih:	106 22 18	106 22 15
Purata ke T.R.	0 00 05	0 00 05
Azimuth T.R. sebenar	106 22 23	106 22 20
Pembetulan aras	+ 0 00 00	+ 0 00 00
Tirusan	- 0 00 04	- 0 00 04
Bering grid T.R.	106 22 19	106 22 16

Purata bering grid T.R. 106 22 18