

No. Fail _____

Rajah di muka _____

[illegible]

No. Fail _____

Rajah di muka _____

Stesen	BEARING / SUDUT			Dari Stn.	GARISAN	Ke Stn.	Sudut Pugak ($\pm$)	Jarak	Suhu	Jarak Antara Tupang	Jarak Mukamat
	Penyilang Kiri	Penyilang Kanan	Purata		Bearing Mukamat						

No. Fail _____

Rajah di muka _____


Stesen	BEARING / SUDUT			Dari Stn.	GARISAN		Ke Stn.	Sudut Pugak ($\pm$)	Jarak	Suhu	Jarak Antara Tupang	Jarak Muklumat
	Penyilang Kiri	Penyilang Kanan	Purata		Bearing Muklumat							
18	232 14 12	52 14 12	10 30 05	10 30 05	10 30 05	20	14	27.574				27.574
5	202 00 34	102 00 34	350 20 03	5	350 20 03	22	14	23.035				23.035
22	350 20 03	70 20 03										
5	202 00 34	102 00 34	350 24 00	5	350 24 00	23	14	21.375				21.375
23	350 24 00	70 24 00										

No. Fail _____


Rajah di muka _____

Stesen	BEARING / SUDUT			Dari Stn.	GARISAN	Ke Stn.	Sudut Pukak ($\pm$)	Jarak	Suhu	Jarak Antara Tupang	Jarak Mukamat
	Penyilang Kiri	Penyilang Kanan	Purata		Bearing Mukamat						
5	282 00 34	102 00 34	350 35 38	5	350 35 38	24A	H	7.637			7.637
	24 350 35 38	10 35 38				14B					
6	102 00 34	282 00 34	146 35 22	6	146 35 22	24	17	3.318			3.318
	24 146 35 22	326 35 22				14B					
7	34 05 10	74 05 10	86 04 30	7	86 04 30	25	H	20.760			20.760
	25 86 04 30	286 04 30				14B					
7		24	24 13 06	7	24 13 06	26	17	12.845			12.845
	26 24 13 06	24 13 06				14B					
7	74 05 10	34 05 10	235 15 41	7	235 15 41	27	17	14.163			14.163
	27 235 15 41	35 15 41				14B					
10	15 06 23	33 06 23	206 54 15	10	206 54 15	28	17	22.651			22.651
	28 206 54 15	26 54 15				14B					
10		24	15 17 05	10	15 17 05	29	17	16.274			16.274
	29 15 17 05	33 17 05				14B					

No. Fail 2801

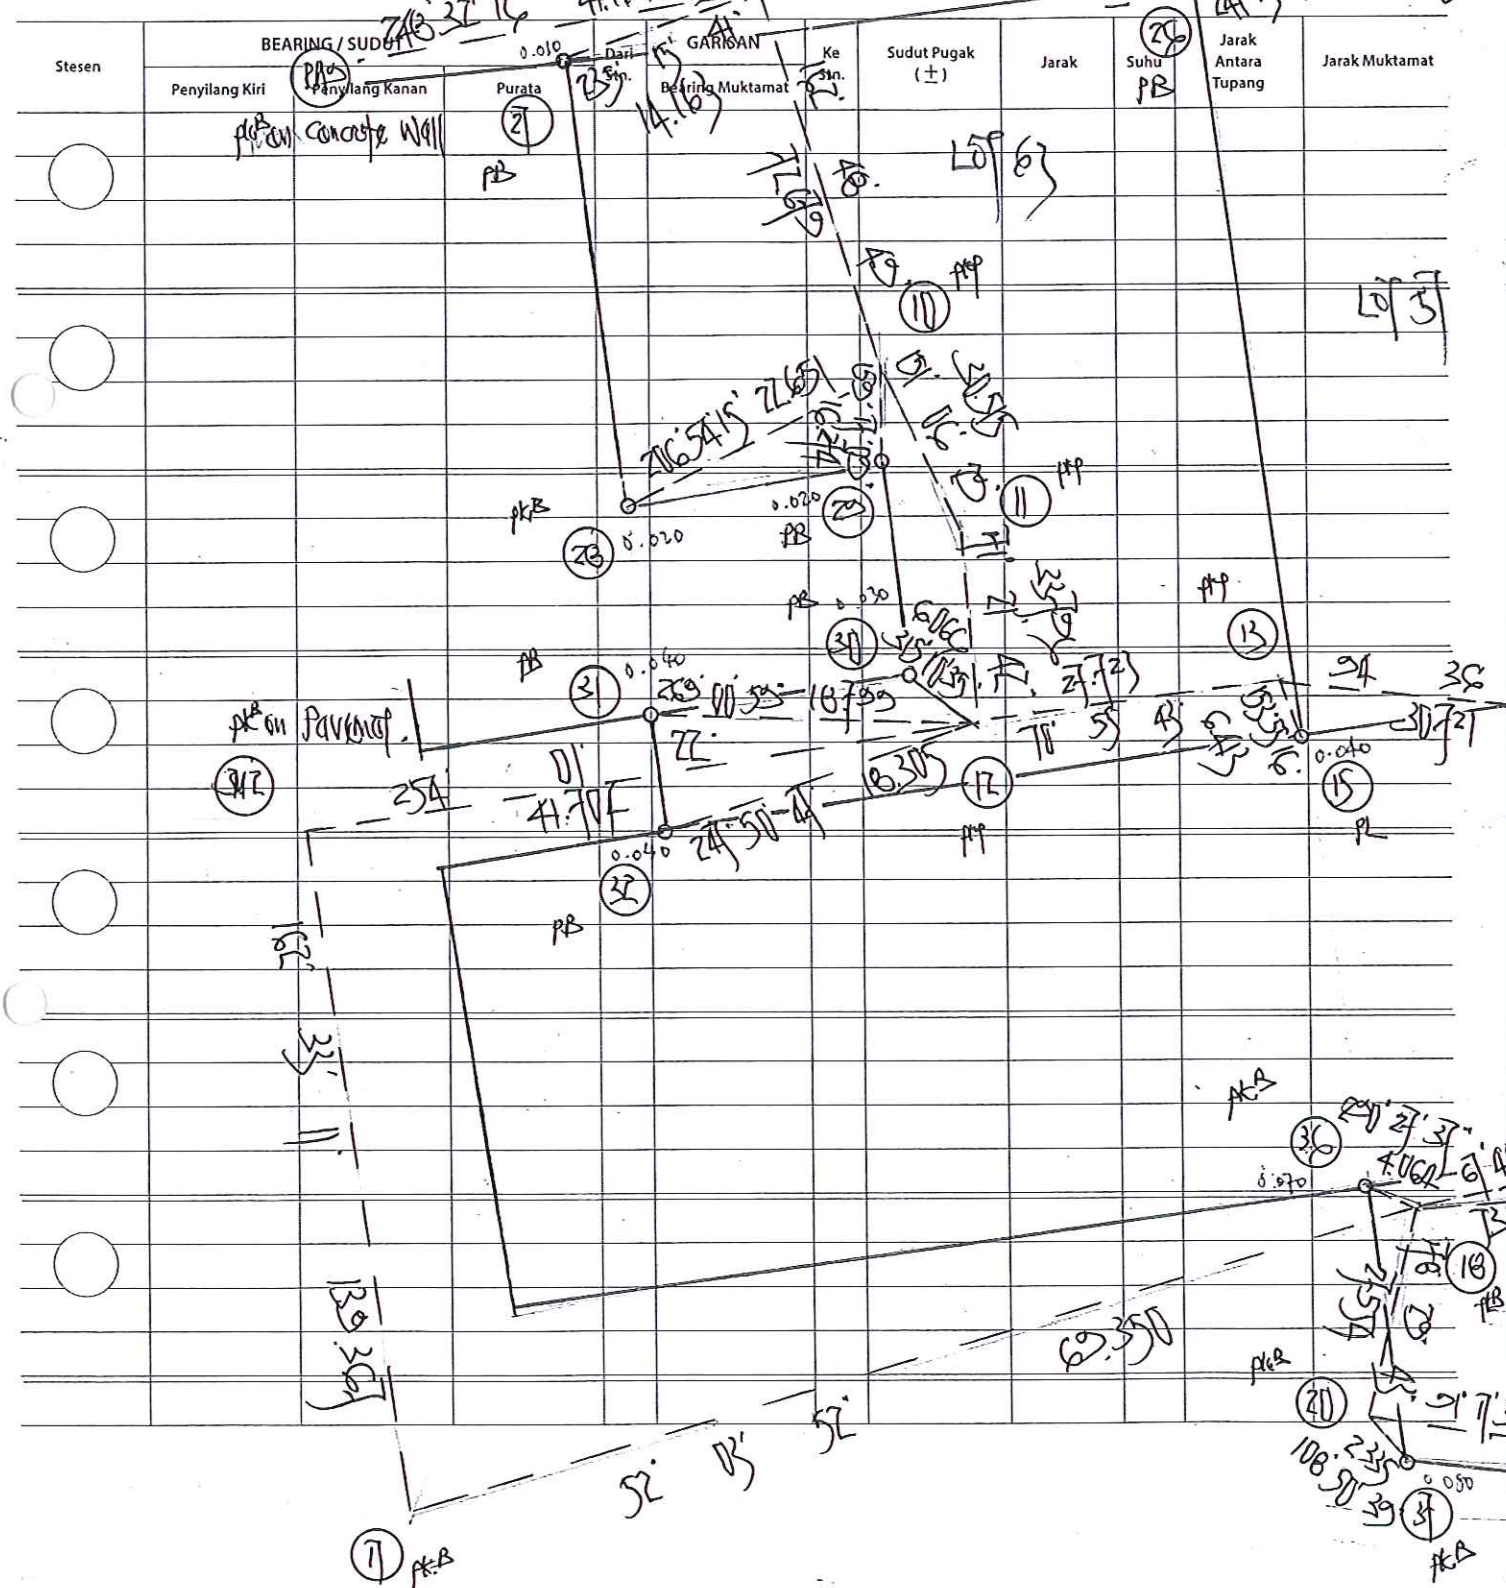

No. Fail

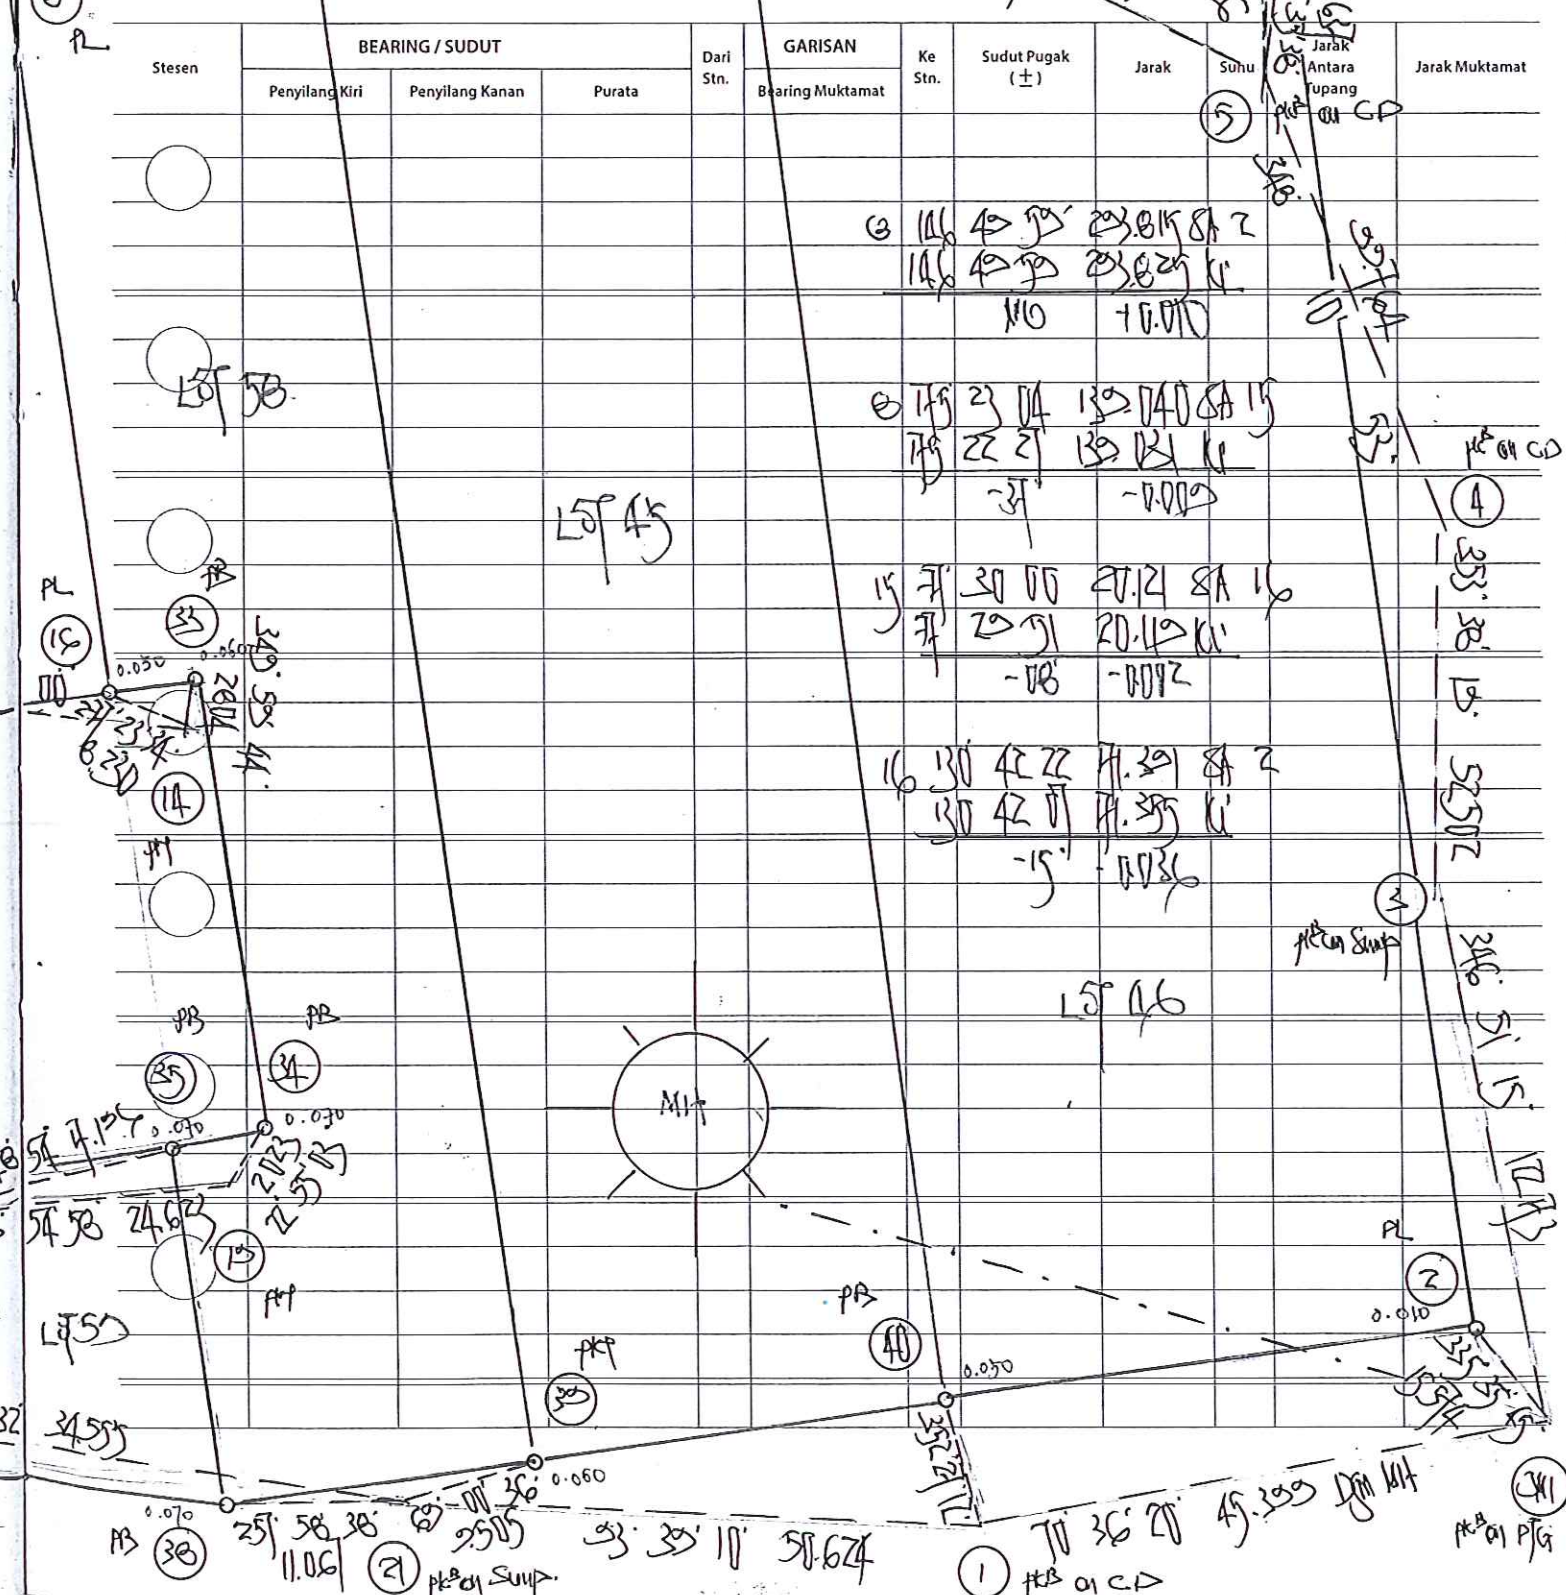

No. Fail _____

Rajah di muka _____

Stesen	BEARING / SUDUT			Dari Stn.	GARISAN	Ke Stn.	Sudut Pugak (±)	Jarak	Suhu	Jarak Antara Tupang	Jarak Muktamat
	Penyilang Kiri	Penyilang Kanan	Purata		Bearing Muktamat						
11 (17)	351 21 42	41 21 42	315 11 35	12 315 11 35	20 PB	14	2165			2165	
	30 35 11 35	15 11 35									
11 (17)		31	30 00 30	12 30 00 30	31 PB	14	10.700			10.700	
	31 30 00 30	65 00 30									
11 (17)		31	34 50 47	12 34 50 47	32 PB	14	10.305			10.305	
	32 34 50 47	67 50 47									
13 (14)	214 36 00	34 36 00	340 30 44	14 340 30 44	33 PB	14	2014			2014	
	33 30 30 44	10 30 44									
13 (15)	21 54 50	35 54 50	22 55 03	15 22 55 03	34 PB	14	2123			2123	
	34 22 55 03	202 55 03									
20 (18)	110 20 45	350 20 45	27 40 54	10 27 40 54	35 PB	14	4100			4100	
	35 27 40 54	247 40 54									
20 (18)		31	32 24 37	10 32 24 37	36 PB	14	4064			4064	
	36 32 24 37	110 24 37									

No. Fail _____

Rajah di muka _____

[illegible]