


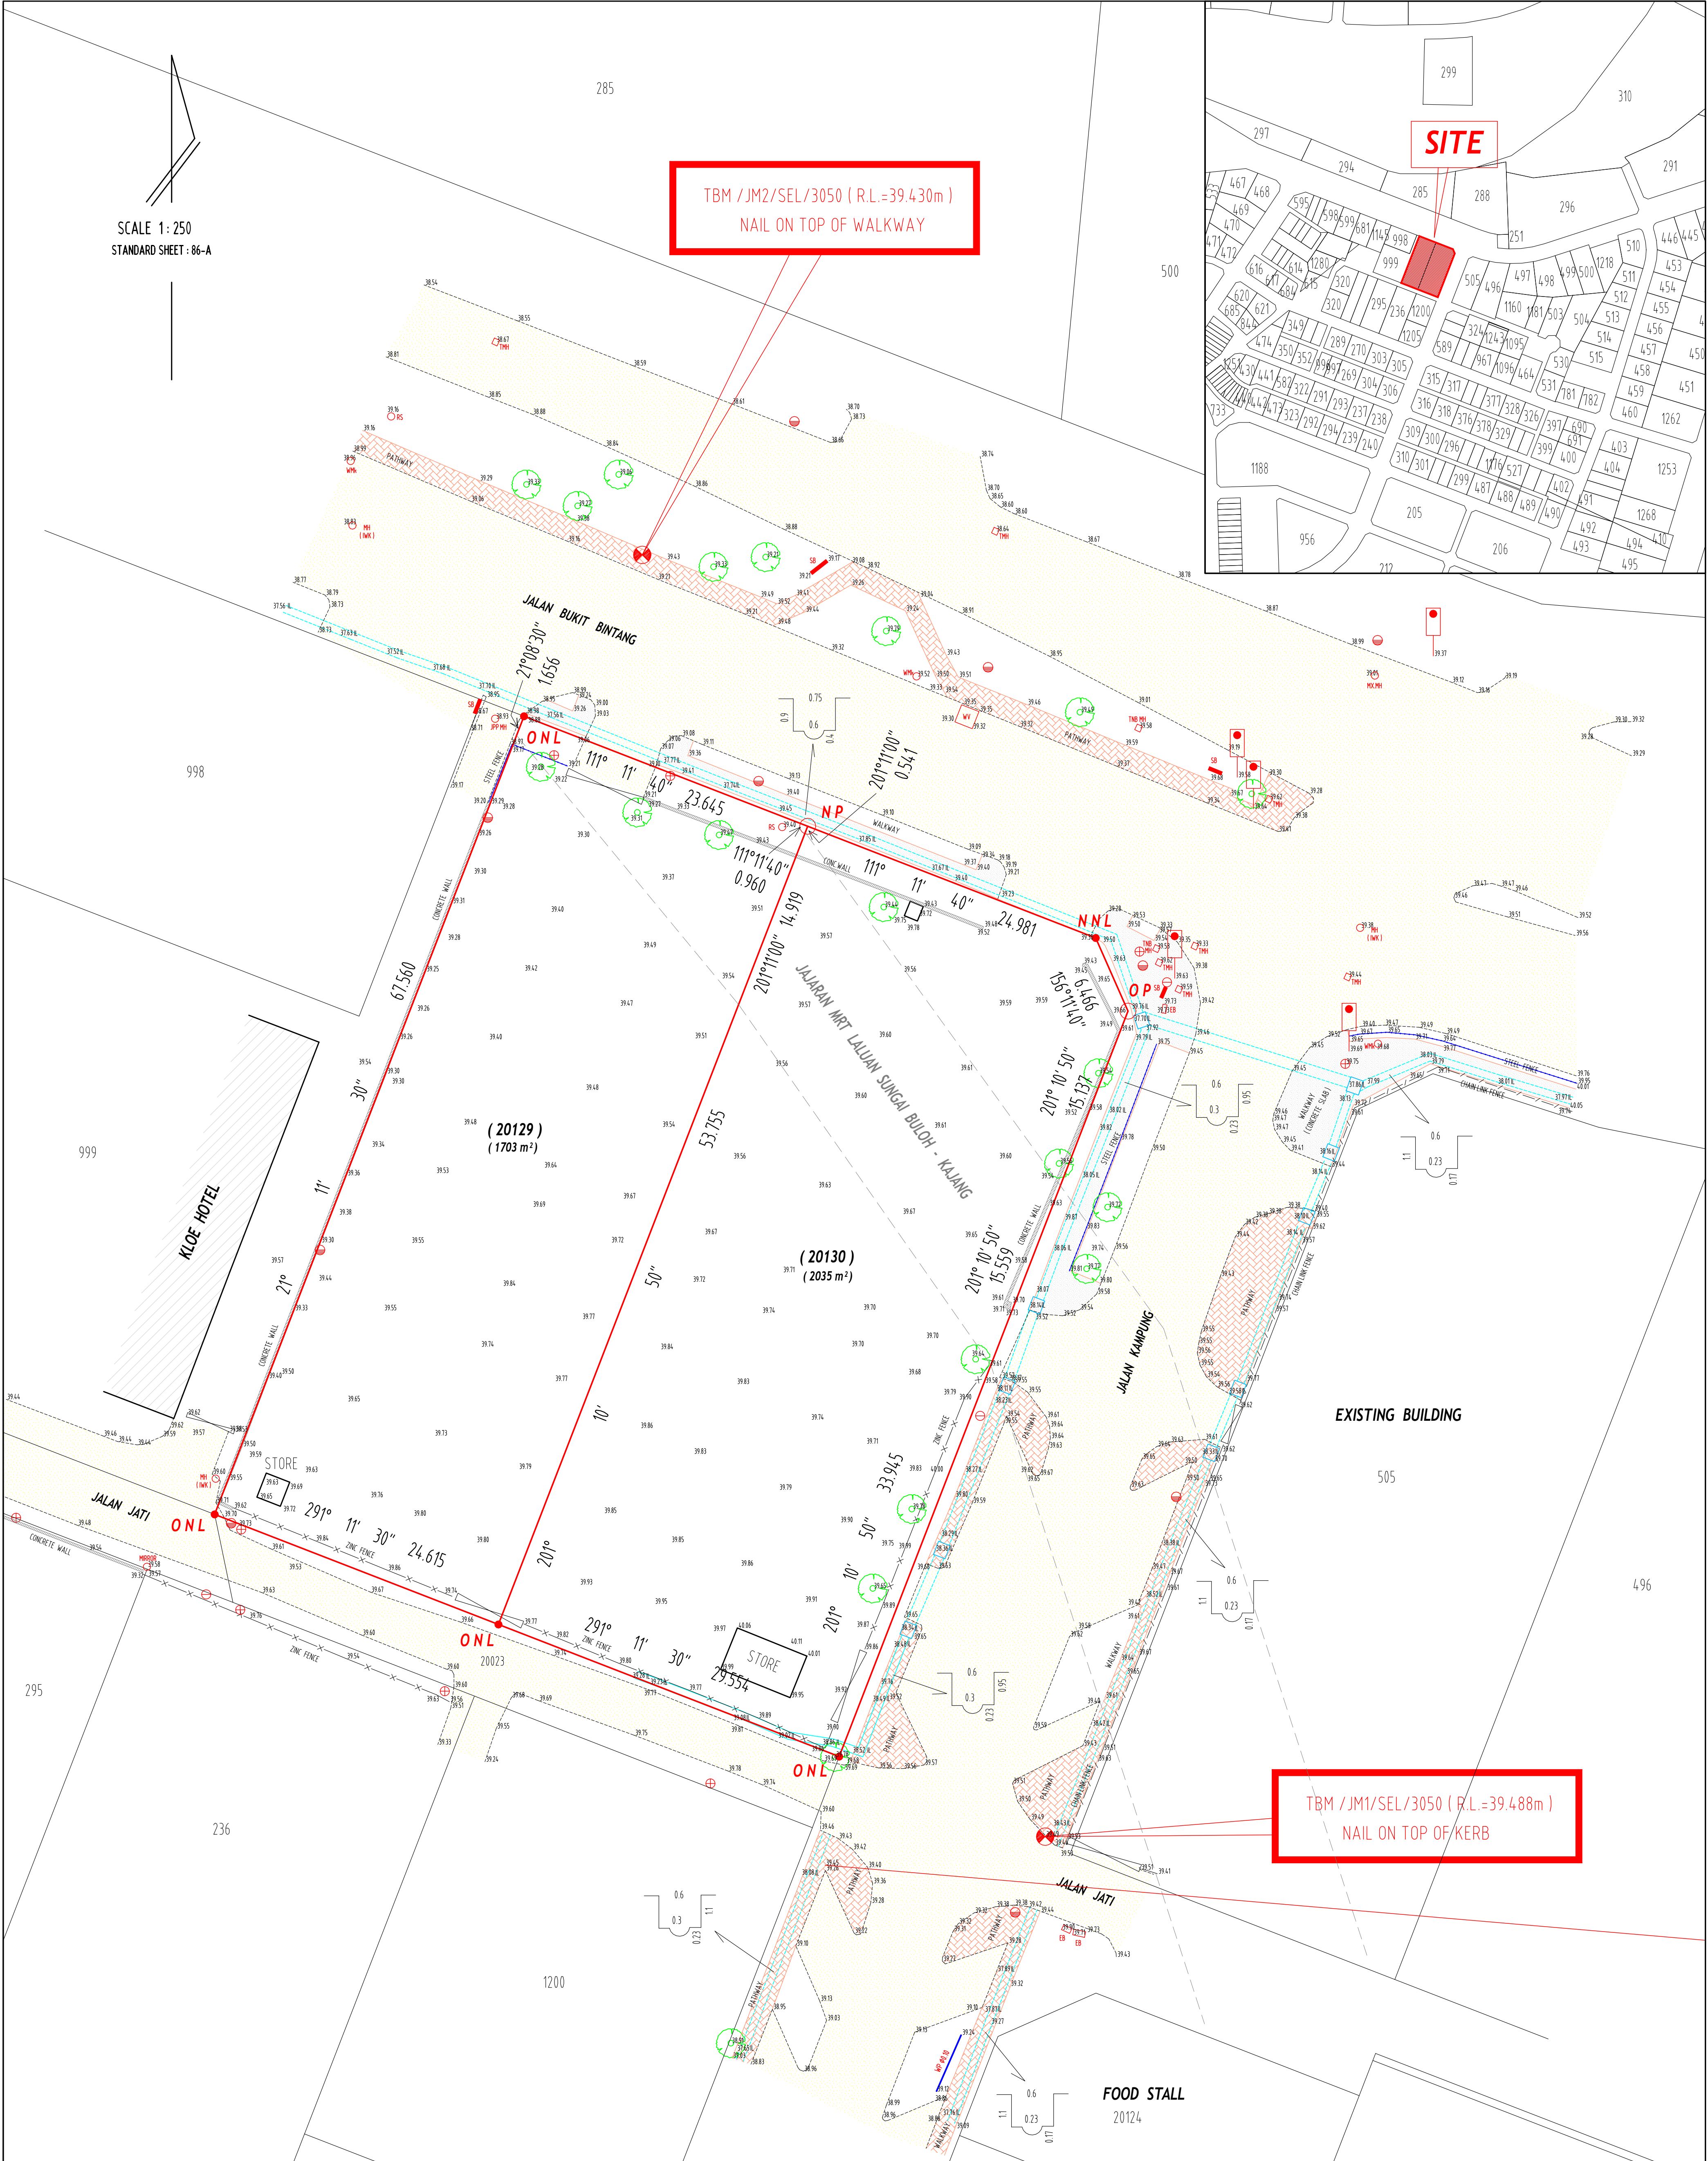

NOTE:

SEMUA ARAS ADALAH BERDASAR DARI BM W 0303 (A.L.=38.741m)
DI KANAN JALAN TUN ABDUL RAZAK - JUPM DE TEPI BENTENG KUNCI AIR
LEBIH KURANG 120 METER SELEPAS JALAN LANGKAP GOLF.

LEGEND:

WMK

- WATER MARKER

⊕

- TELEPHONE POST

⊕

- LAMP POST

⊕

- ELECTRIC POST

EB

- ELECTRIC BOX

SB

- SIGN BOARD

MH

- MANHOLE

TMH

- TELECOM MANHOLE

WV

- WATER VALVE

TNB Mk

- TNB MARKER

RS

- ROADSIGN

JPP MH

- JPP MANHOLE

●

- TRAFFIC LIGHT

ONL

- OLD NAIL

NNL

- NEW NAIL

OP

- OLD PIPE

NP

- NEW PIPE

TITLE

DEMARCATON , DETAIL & SPOT LEVEL SURVEY

ON LOTS 20129 (OLD LOT 380) &

20130 (OLD LOT 381) , SECTION 67 ,

TOWN OF KUALA LUMPUR ,

DISTRICT OF KUALA LUMPUR ,

WILAYAH PERSEKUTUAN.

H'NG KIM POR

© Sur. (Hons.) (Land) MIS (M)

Land Surveyor Licensed Under Act 458 (Revised 1991)

JURUKUR MURNI

LICENSED LAND SURVEYOR

No. 35-1, Jalan 16/155C, Bandar Bukit Jalil

57000 Kuala Lumpur, Malaysia

Tel : 03-89940029/89940069

Fax : 03-89940039

Email : jnmurni@streamyx.com/ jnmurni@gmail.com

SURVEYED BY : F00

COMPUTED BY : FRZ

DRAWN BY : FRZ

CHECKED BY : H'NG K P

PLAN NO. : JM/E/23/SEL/3050

DIGITAL FILE : JMSSEL3050