

APPENDIX A:
(CERTIFIED PLAN)

PLAN
of Portions 3587 - 3610
surveyed for issue of title by entry in the mukim register
MUKIM OF BATU
DISTRICT OF KUALA LUMPUR


Scale Four Chains to an Inch

Note:
This Survey cancels original Por: 2198

This is App. 13-17 as shown in F.B. and Field tracing, but on the tracing attached to R-D it is a Malay Cemetery.

Extracts for Portions 3587 to 3599 & 3591 to 3610 forwarded Vide Svy: 676-17

723-26 do
840-28 do
359-27 do
829-27 do
3596-3598 & 3600 do
3599 & 3604 do
3598, 3602 & 3603 do
3601 & 3605 do

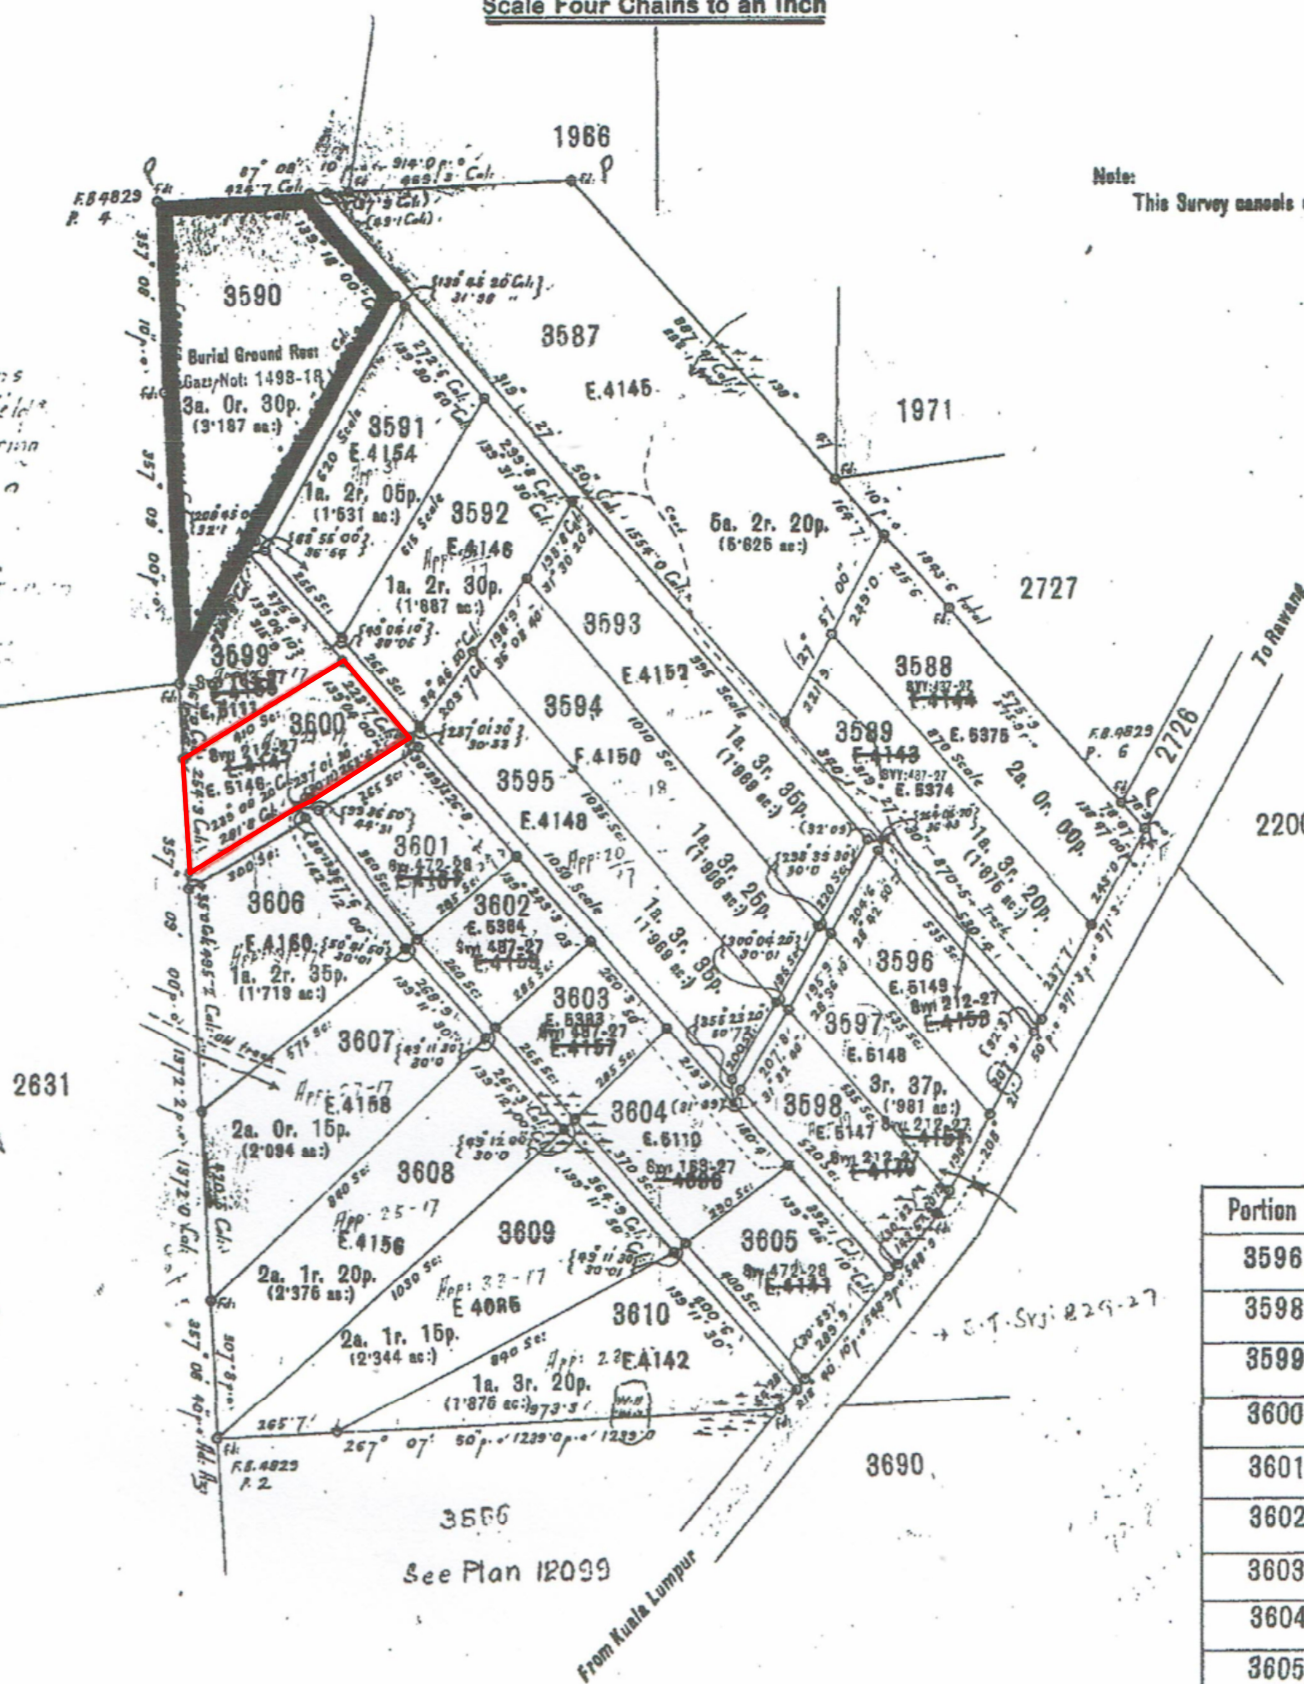

Portion No:	Area
3596	1a. Or. 05p. (1'091 ac.)
3598	1a. Or. 05p. (1'031 ac.)
3599	3r. 07p. (784 ac.)
3600	1a. Or. 15p. (1'094 ac.)
3601	3r. 31p. (944 ac.)
3602	2r. 37p. (731 ac.)
3603	3r. 03p. (789 ac.)
3604	1a. Or. 15p. (1'094 ac.)
3605	1a. Or. 05p. (1'031 ac.)

Third Class Survey

I hereby certify that I have examined the boundaries delineated on this plan and that they are correctly located on the ground and marked as shown hereon.

Drawn by *Matip-pis* 2.11.17

Examined by *CRDnn* 12.11.17

Charted by *Mohamed Ali* 17/12/17

Plan approved *Caedillog* 12/12/17

Cal. Book Vol. 107 P 112 Cal. Book Vol. 190 p. 19 Sheet No. G 10. c-69

Raja Han
Settlement Officer.
10.12.17

Surveyed by Mr. Osman
4.9.17

Examined by *adgoulding*
District Surveyor

Plan No. 12115