


[illegible]

Stesen	BEARING / SUDUT			Dari Stn.	GARISAN	Ke Stn.	Sudut Pukak (±)	Jarak	Suhu	Jarak Antara Tupang	Jarak Muklumat
	Penyilang Kiri	Penyilang Kanan	Purata		Bearing Muklumat						
1	2 23 27	182 23 27	276 08 03	1	276 08 03	2	519	6147	mls	7 R	1
	2 276 08 03	96 08 03			Bening Tertutup						
9-10	93 96 96	223 96 96		9	93 96 96	10	4	28.006		PL	28.006
9-11	11 59 47	191 59 47		9	11 59 47	11	4	9.970		PL	9.970
	Demamante.										
9-12	273 21 00			9	273 21 00	12	4	36.065			36.065
3-13	129 58 37			3	129 58 37	13	4	19.997			19.997
8-9-19	215 33 29			9	215 33 29	19	4	7.782			7.782

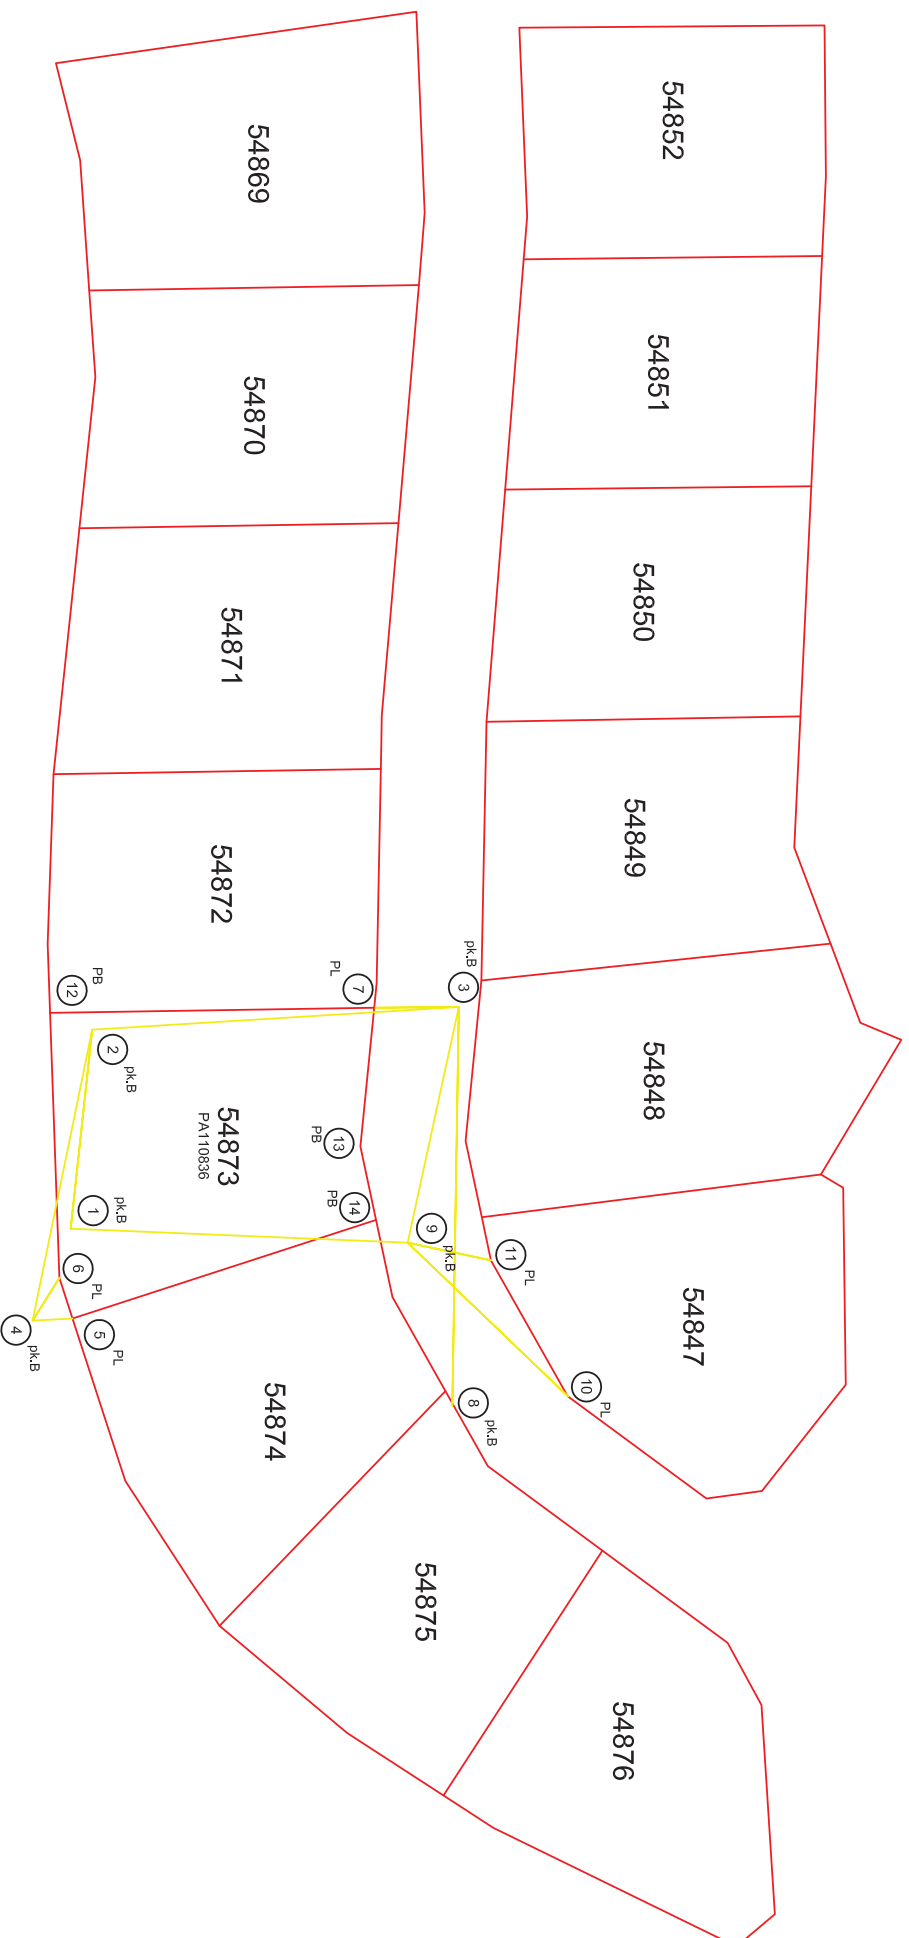

7-5 134°07'52" 50.749(New)

134°08'12" 50.753(Po)

20 -0.003

Penilik: JZ745 Bangsar Hill Tarikh: 29/05/2026
 Stn. 2 Koordinat: S3772 B4177 W.P. Kuala Lumpur
 T.R. 1 B.K. Ms.
 Tiodolit Satu bah. aras ufuk:

Waktu	Sasaran	Ufuk	Gelembong	Puguk		
	T.R.	270 00 00				
17 55	M.H.	285 55 45		71 28 46	Waktu purata	17 55 30
17 55	M.H.	285 22 08		71 31 35	Beza dari U.T. -	8 00 00
17 56	M.H.	105 21 31		288 22 24	U.T.	9 55 30
17 56	M.H.	105 54 46		288 18 57	Deklinasi	21 39 02
	T.R.	90 00 00				

	T.R.	270 00 00				
17 57	M.H.	285 54 15		71 47 41	Waktu purata	17 57 30
17 57	M.H.	285 20 42		71 50 22	Beza dari U.T. -	8 00 00
17 58	M.H.	105 20 27		288 05 14	U.T.	9 57 30
17 58	M.H.	105 53 35		288 01 07	Deklinasi	21 39 03
	T.R.	90 00 00				

	Set 1	Set 2
Sudut pugak	18 25 15	18 07 05
Pembetulan	- 0 02 30	- 0 02 33
Altitud	18 22 45	18 04 32
Jarak kutub	68 20 58	68 20 57
Latitud	3 08 24	3 08 24
Azimut M.H. yang dikira	291 47 08	291 45 50
Purata ke M.H.	285 38 32	285 37 15
Selisih:	6 08 36	6 08 35
Purata ke T.R.	270 00 00	270 00 00
Azimuth T.R. sebenar	276 08 36	276 08 35
Pembetulan aras	+ 0 00 00	+ 0 00 00
Tirusan	- 0 00 31	- 0 00 31
Bering grid T.R.	276 08 05	276 08 04

Purata bering grid T.R. 276 08 05

JZ 795 Bangor Hill

0.3662

109.811

GPS

1.2697

103.913

F3

2.5006

102.677

F9

2.9697

102.708

TBM JZ1

1.1744

109.003

TBM JZ2

BM B0727

GPS Level: 95.773 (Baro)

BM Level: 95.773

GPS

109.811