



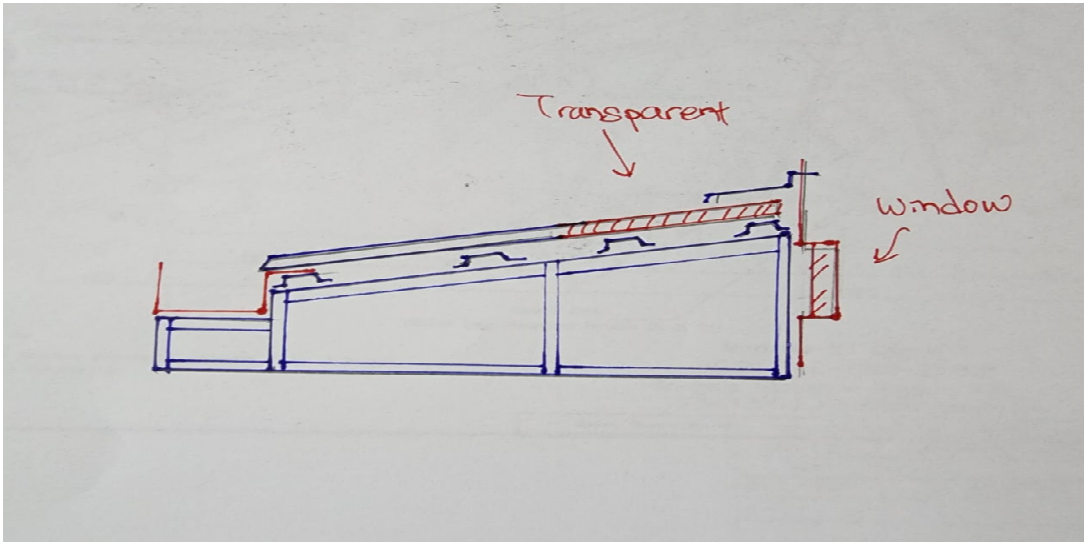

PROPOSAL FOR METAL DECK ROOF

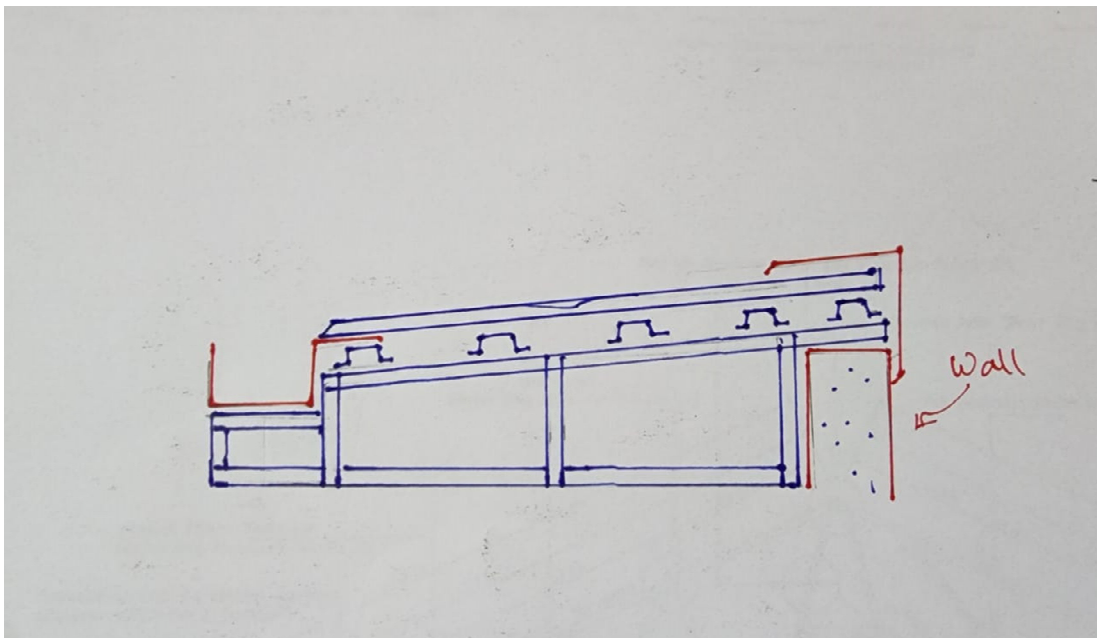

PROPOSAL FOR METAL DECK ROOF (Window Area)